

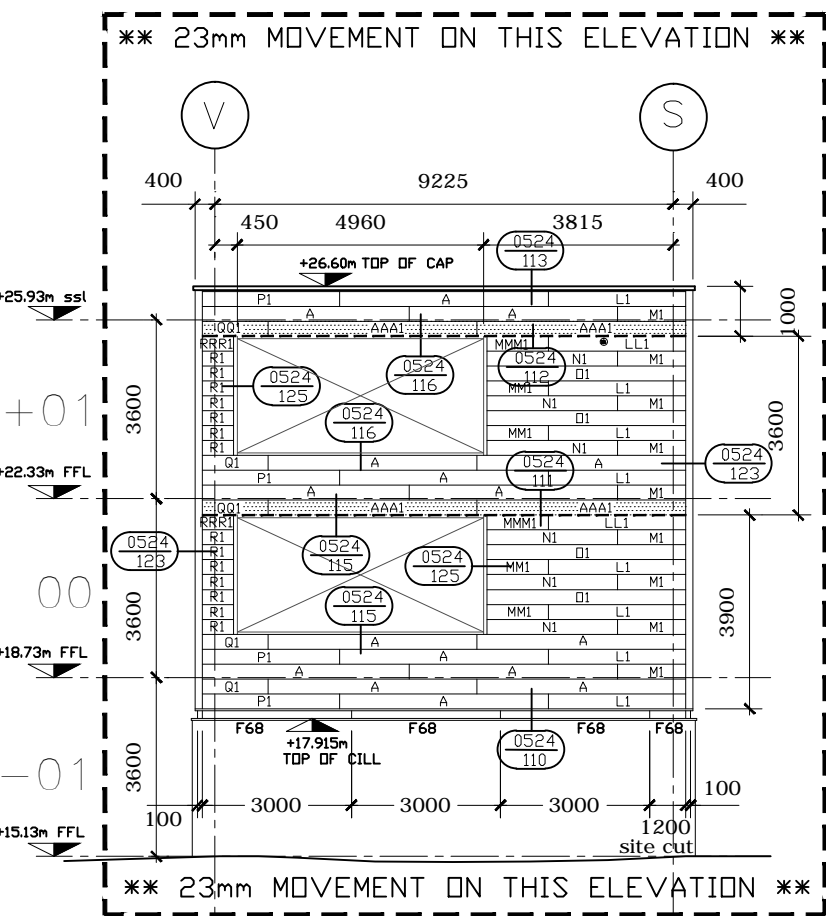



ELEVATION ON G.L. N
WEST ELEVATION

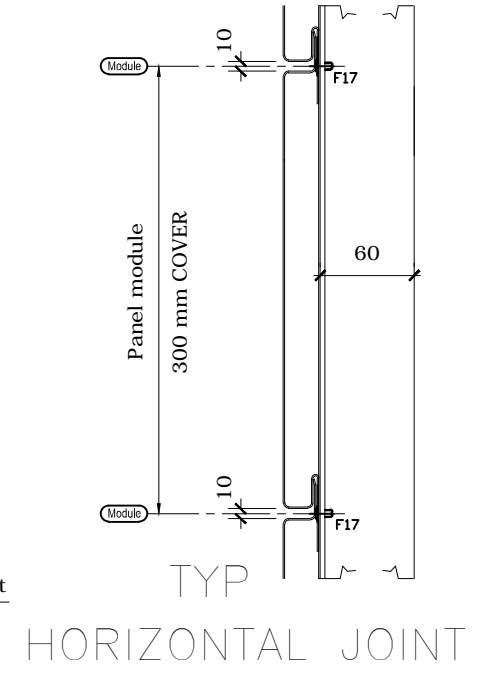


ELEVATION ON G.L. 8
NORTH ELEVATION

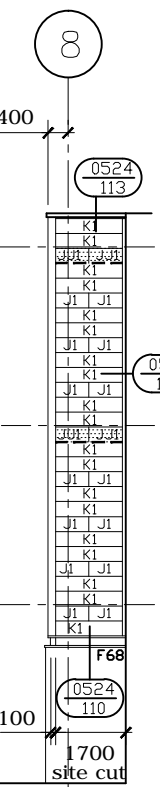

G.L. S
NORTH ELEVATION


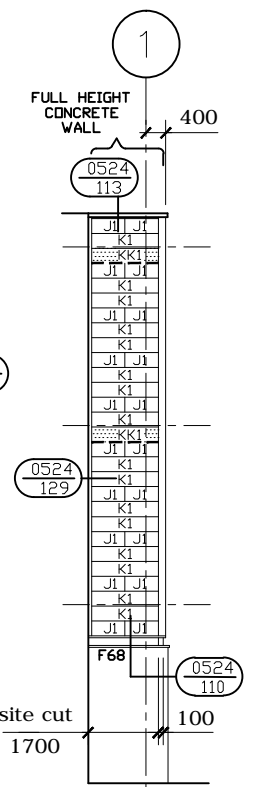


G.L. P
NORTH ELEVATION

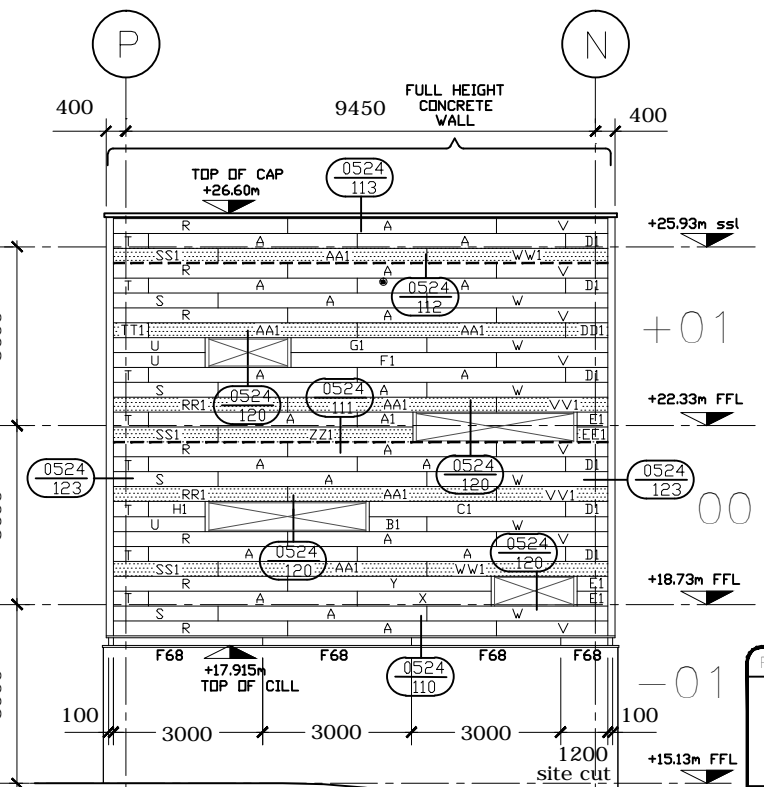

ELEVATION ON G.L. 1
NORTH ELEVATION

----- : 10mm MOVEMENT JOINT
OR 23mm ON G.L. 8 ONLY

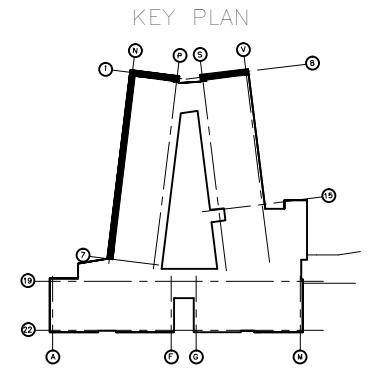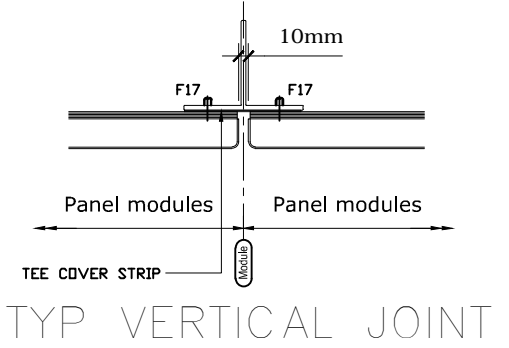

• : WEIR OVERFLOW LOCATION (by others)

REVS	ALL DIMENSIONS IN MILLIMETRES U.N.D	
A	UPDATED TO COMMENTS	20.02.10
B	DRG UPDATED	15.03.10
C	DRG UPDATED	30.03.10
D	REF'S UPDATED	06.04.10
AS BUILT		
Client	SKANSKA	ARCHITECT CUBE DESIGN
Project	ASHTON PARK SCHOOL BRISTOL	
Title	ELEVATIONS ON G.L. N, 1, P, S & 8	
Scale	1:100 @ A2	
Date	01/01/10	Drawing No.
Drawn	SJS	0524-101
TEL : 01275 464372 FAX : 01275 464863		MASSEY CLADDING SOLUTIONS LTD.
		TOTAL ROOF & WALL CLADDING SOLUTIONS