


TYP GUTTER G03 JOINT

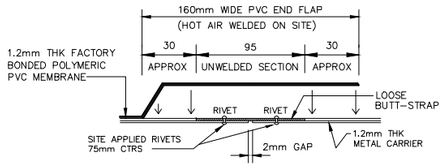


BONDED BUTT STRAP
F37,38,39

F42 : 2mm THK GALV STEEL ANGLE FLASHING @ 3m LG

F34 : 1.6mm THK GALV STEEL ANGLE FLASHING @ 3m LG

F36 : 1.6mm THK GALV STEEL ZED FLASHING @ 3m LG

F38 : 2mm THK ALUMINIUM EAVES FIN FEATURE FLASHING
PPC COATED COLOUR REF : G/GREY 10 A 05

F39 : 2mm THK ALUMINIUM EAVES SOFFIT FLASHING
PPC COATED COLOUR REF : G/GREY 10 A 05

F10 : 2mm THK ALUMINIUM SOFFIT CLOSURE FLASHING
PPC COATED COLOUR REF : G/GREY 10 A 05

F01 : 1.6mm THK GALV STEEL TOP-HAT STOOL @ 1m crs

F02 : 1.6mm THK GALV STEEL TOP-HAT FLASHING @ 3m LG

F35 : 1.6mm THK GALV STEEL ANGLE FLASHING @ 3m LG

F37 : 2mm THK ALUMINIUM EAVES FEATURE FLASHING
PPC COATED COLOUR REF : G/GREY 10 A 05

F05 : 1.6mm THK GALV STEEL ANGLE FLASHING @ 3m LG

F41 : 0.7mm THK STEEL LINER CLOSURE FLASHING @ 3m
COLOUR REF : STD BRIGHT WHITE







SECTION X-X

| REVS | ALL DIMENSIONS IN MILLIMETRES U.N.O | |
|---|---|---|
| A | ISSUE FOR CONSTRUCTION | 10/09 |
| | *AS BUILT ISSUE* | |

Client: KIER GROUP
Architect: POWELL DOBSON
Project: HOLLYBUSH PRIMARY SCHOOL
Title: EAVES DETAIL AT G.L M CENTRAL SPINE ROOF

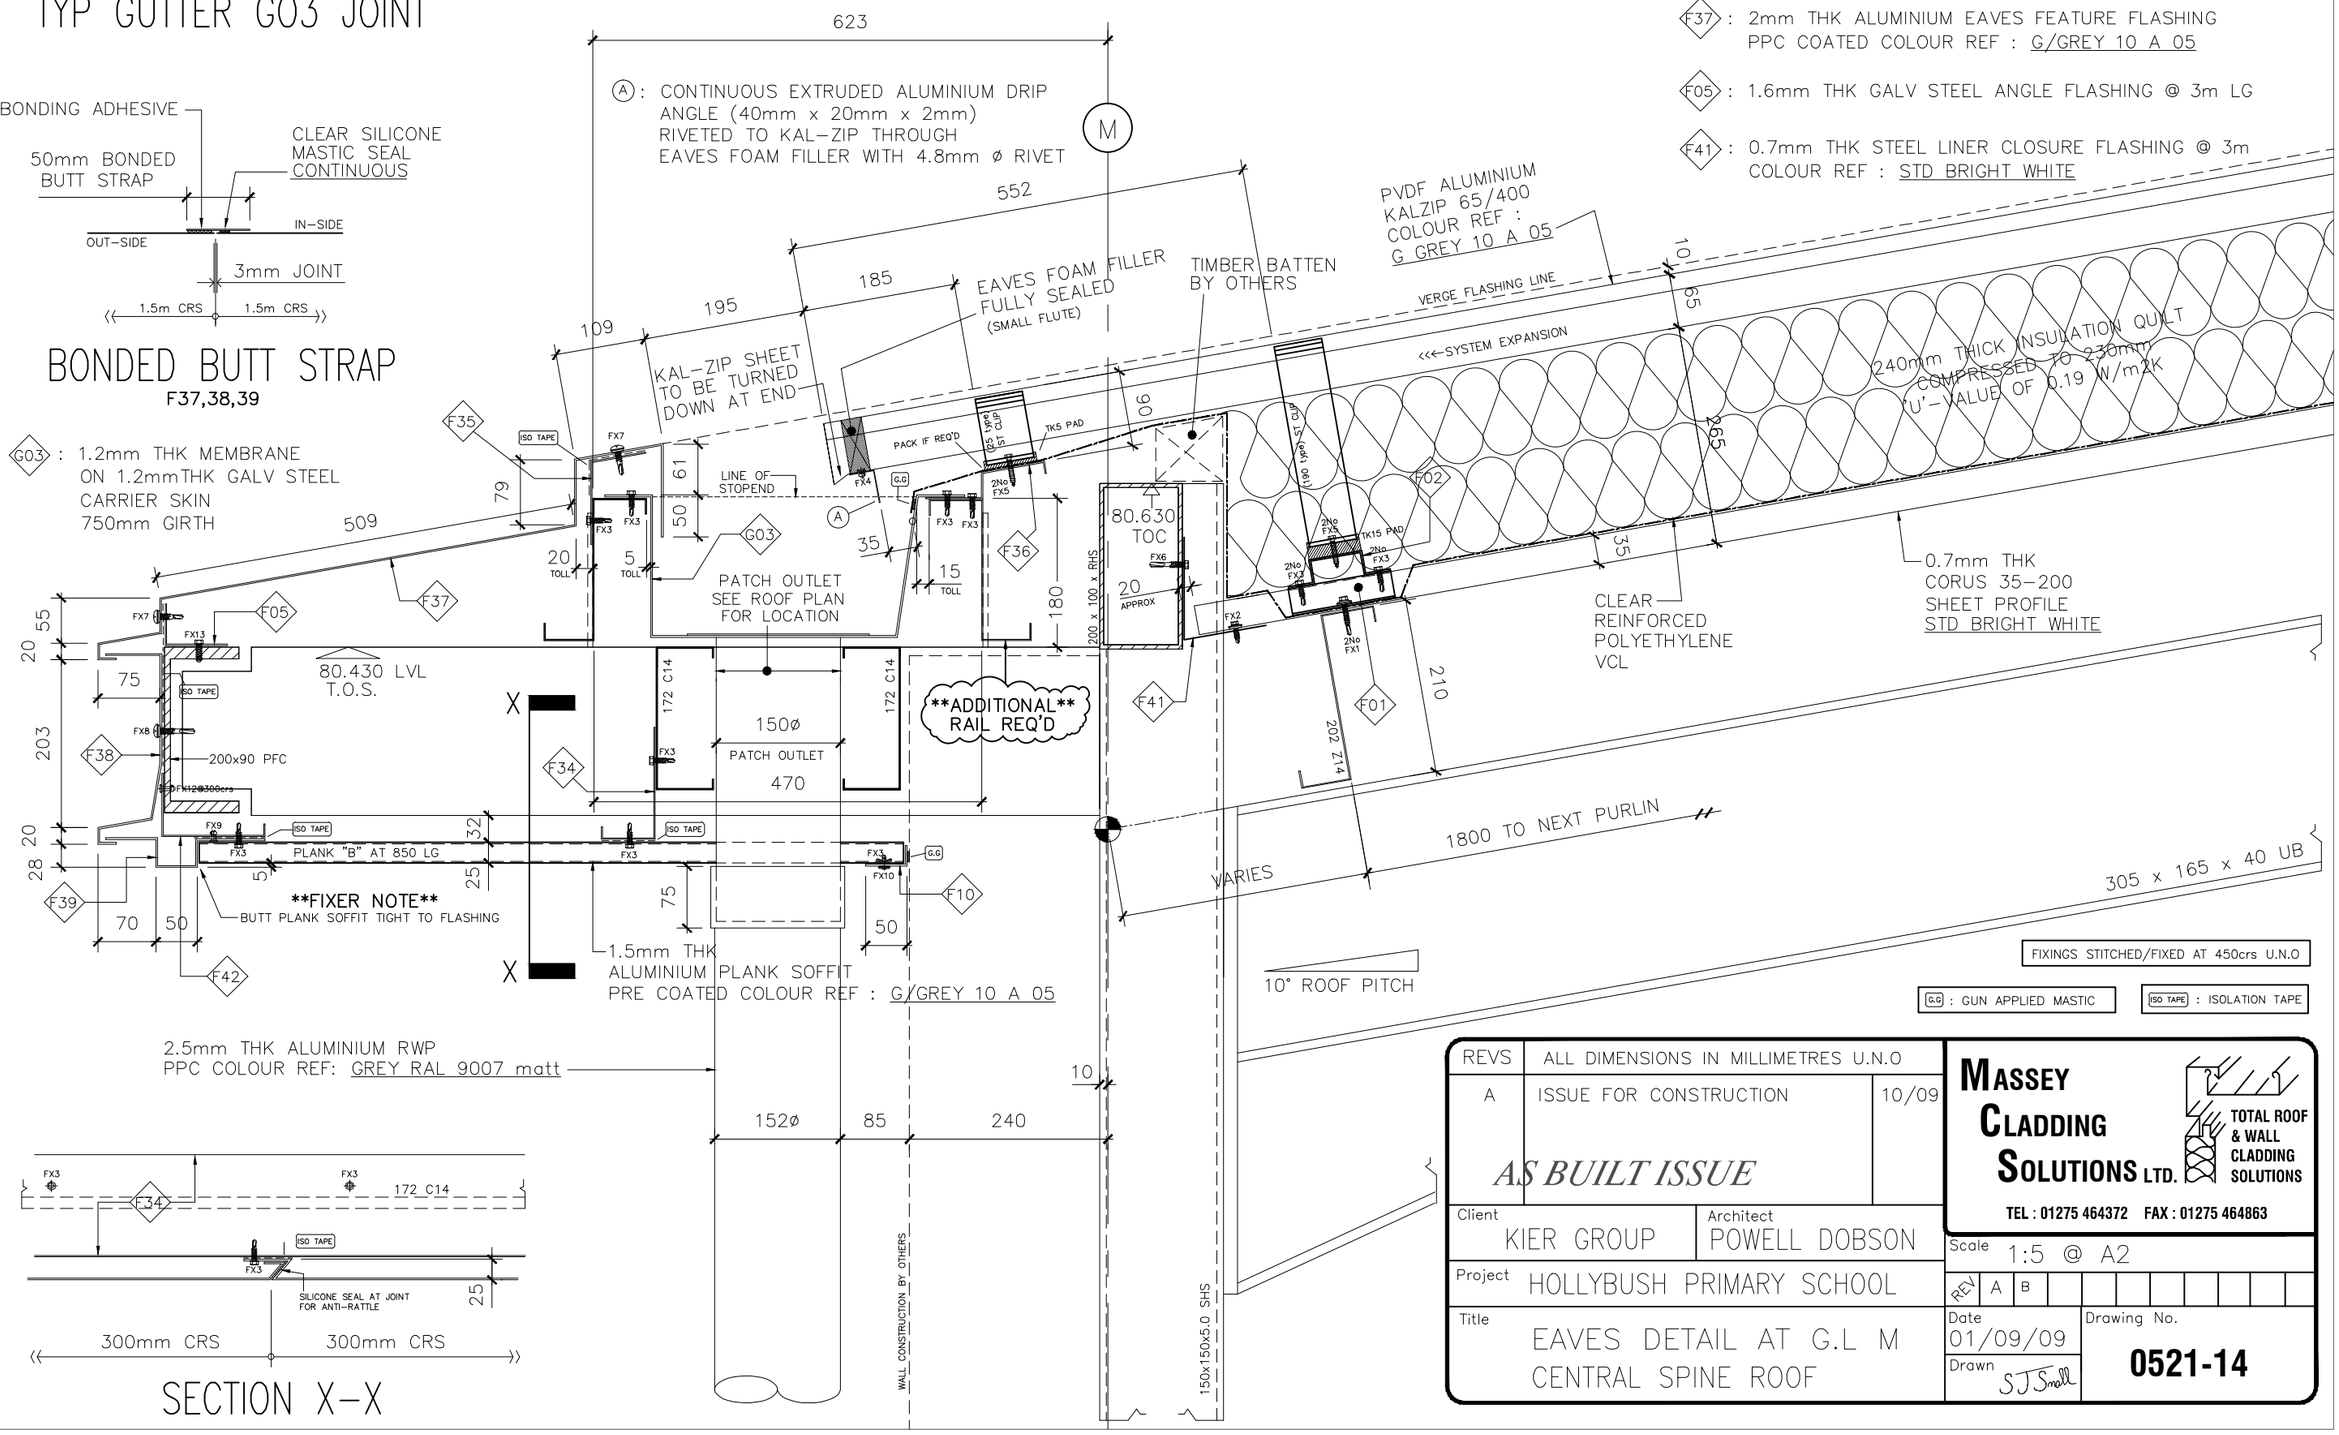
MASSEY CLADDING SOLUTIONS LTD.
TOTAL ROOF & WALL CLADDING SOLUTIONS
TEL : 01275 464372 FAX : 01275 464863


Scale: 1:5 @ A2
REV: A B
Date: 01/09/09
Drawn: S J Small
Drawing No. 0521-14