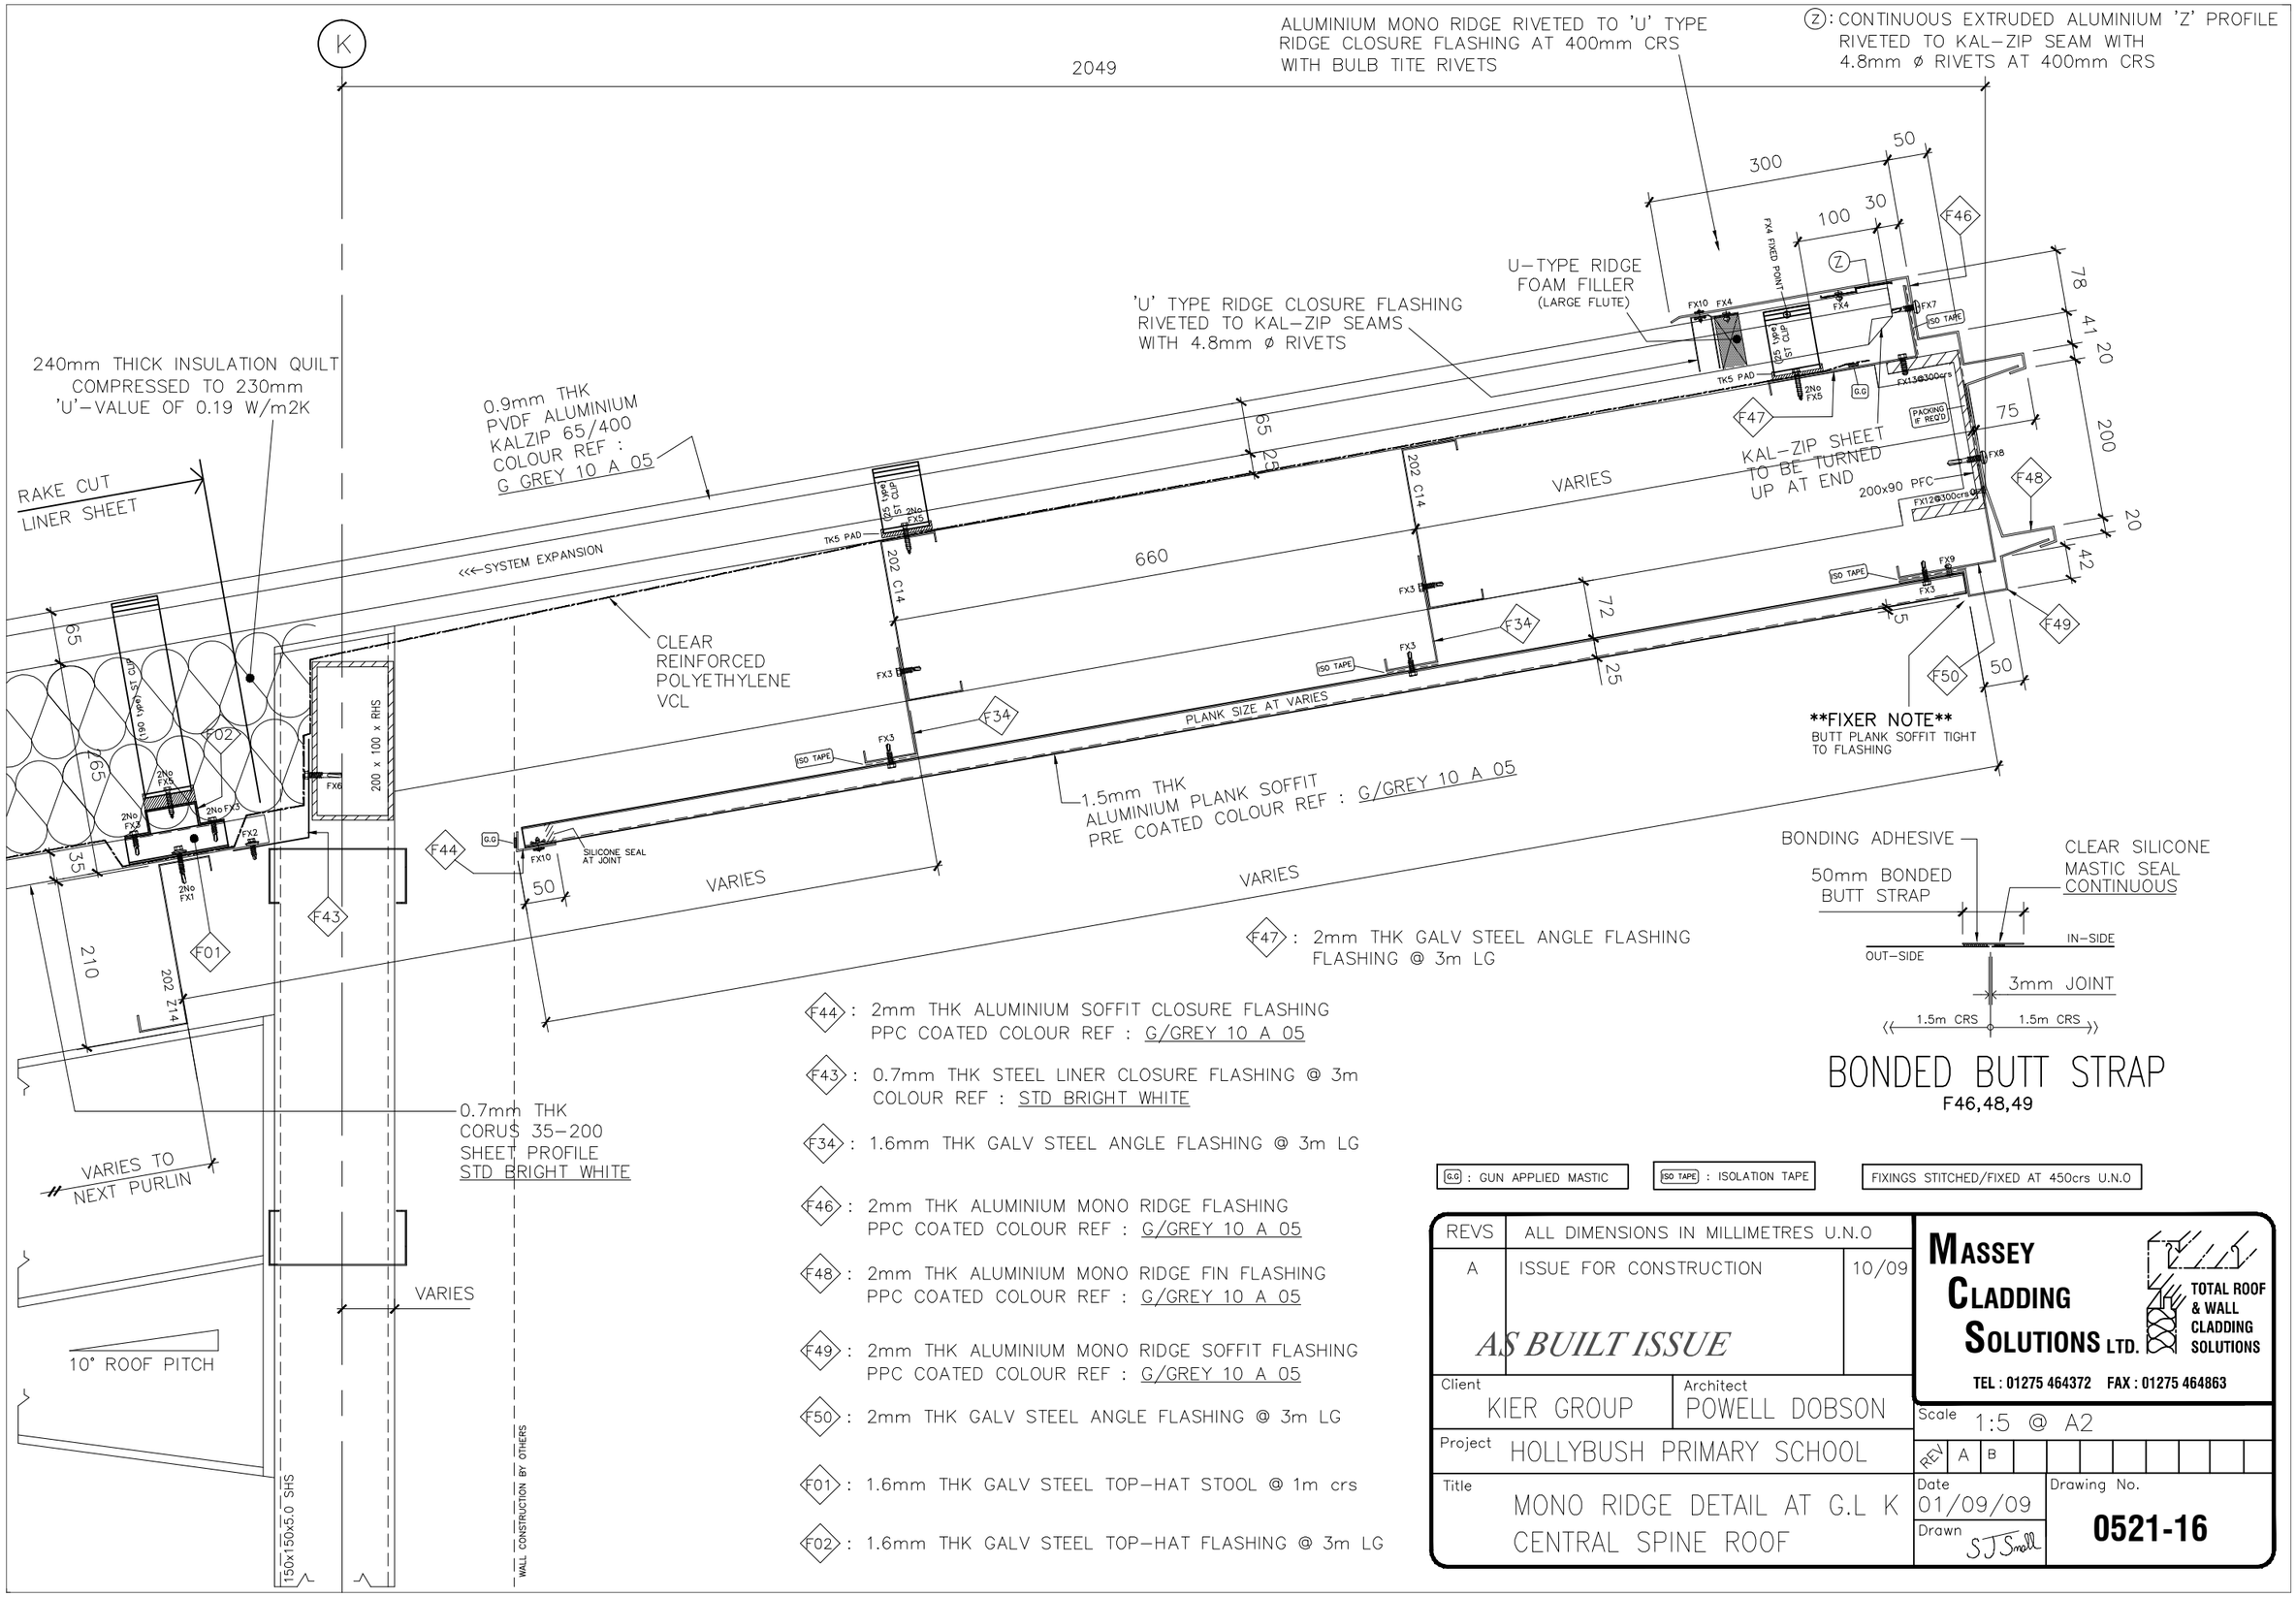

BONDED BUTT STRAP
F46,48,49

F47 : 2mm THK GALV STEEL ANGLE FLASHING FLASHING @ 3m LG

F44 : 2mm THK ALUMINIUM SOFFIT CLOSURE FLASHING PPC COATED COLOUR REF : G/GREY 10 A 05

F43 : 0.7mm THK STEEL LINER CLOSURE FLASHING @ 3m COLOUR REF : STD BRIGHT WHITE

F34 : 1.6mm THK GALV STEEL ANGLE FLASHING @ 3m LG

F46 : 2mm THK ALUMINIUM MONO RIDGE FLASHING PPC COATED COLOUR REF : G/GREY 10 A 05

F48 : 2mm THK ALUMINIUM MONO RIDGE FIN FLASHING PPC COATED COLOUR REF : G/GREY 10 A 05

F49 : 2mm THK ALUMINIUM MONO RIDGE SOFFIT FLASHING PPC COATED COLOUR REF : G/GREY 10 A 05

F50 : 2mm THK GALV STEEL ANGLE FLASHING @ 3m LG

F01 : 1.6mm THK GALV STEEL TOP-HAT STOOL @ 1m crs

F02 : 1.6mm THK GALV STEEL TOP-HAT FLASHING @ 3m LG

G.G : GUN APPLIED MASTIC

ISO TAPE : ISOLATION TAPE

FIXINGS STITCHED/FIXED AT 450crs U.N.O

REVS	ALL DIMENSIONS IN MILLIMETRES U.N.O	
A	ISSUE FOR CONSTRUCTION	10/09
	AS BUILT ISSUE	

MASSEY CLADDING SOLUTIONS LTD.
TOTAL ROOF & WALL CLADDING SOLUTIONS
TEL : 01275 464372 FAX : 01275 464863

Client: KIER GROUP
Architect: POWELL DOBSON
Project: HOLLYBUSH PRIMARY SCHOOL
Title: MONO RIDGE DETAIL AT G.L K CENTRAL SPINE ROOF
Scale: 1:5 @ A2
REV: A B
Date: 01/09/09
Drawn: S J Small
Drawing No. **0521-16**